


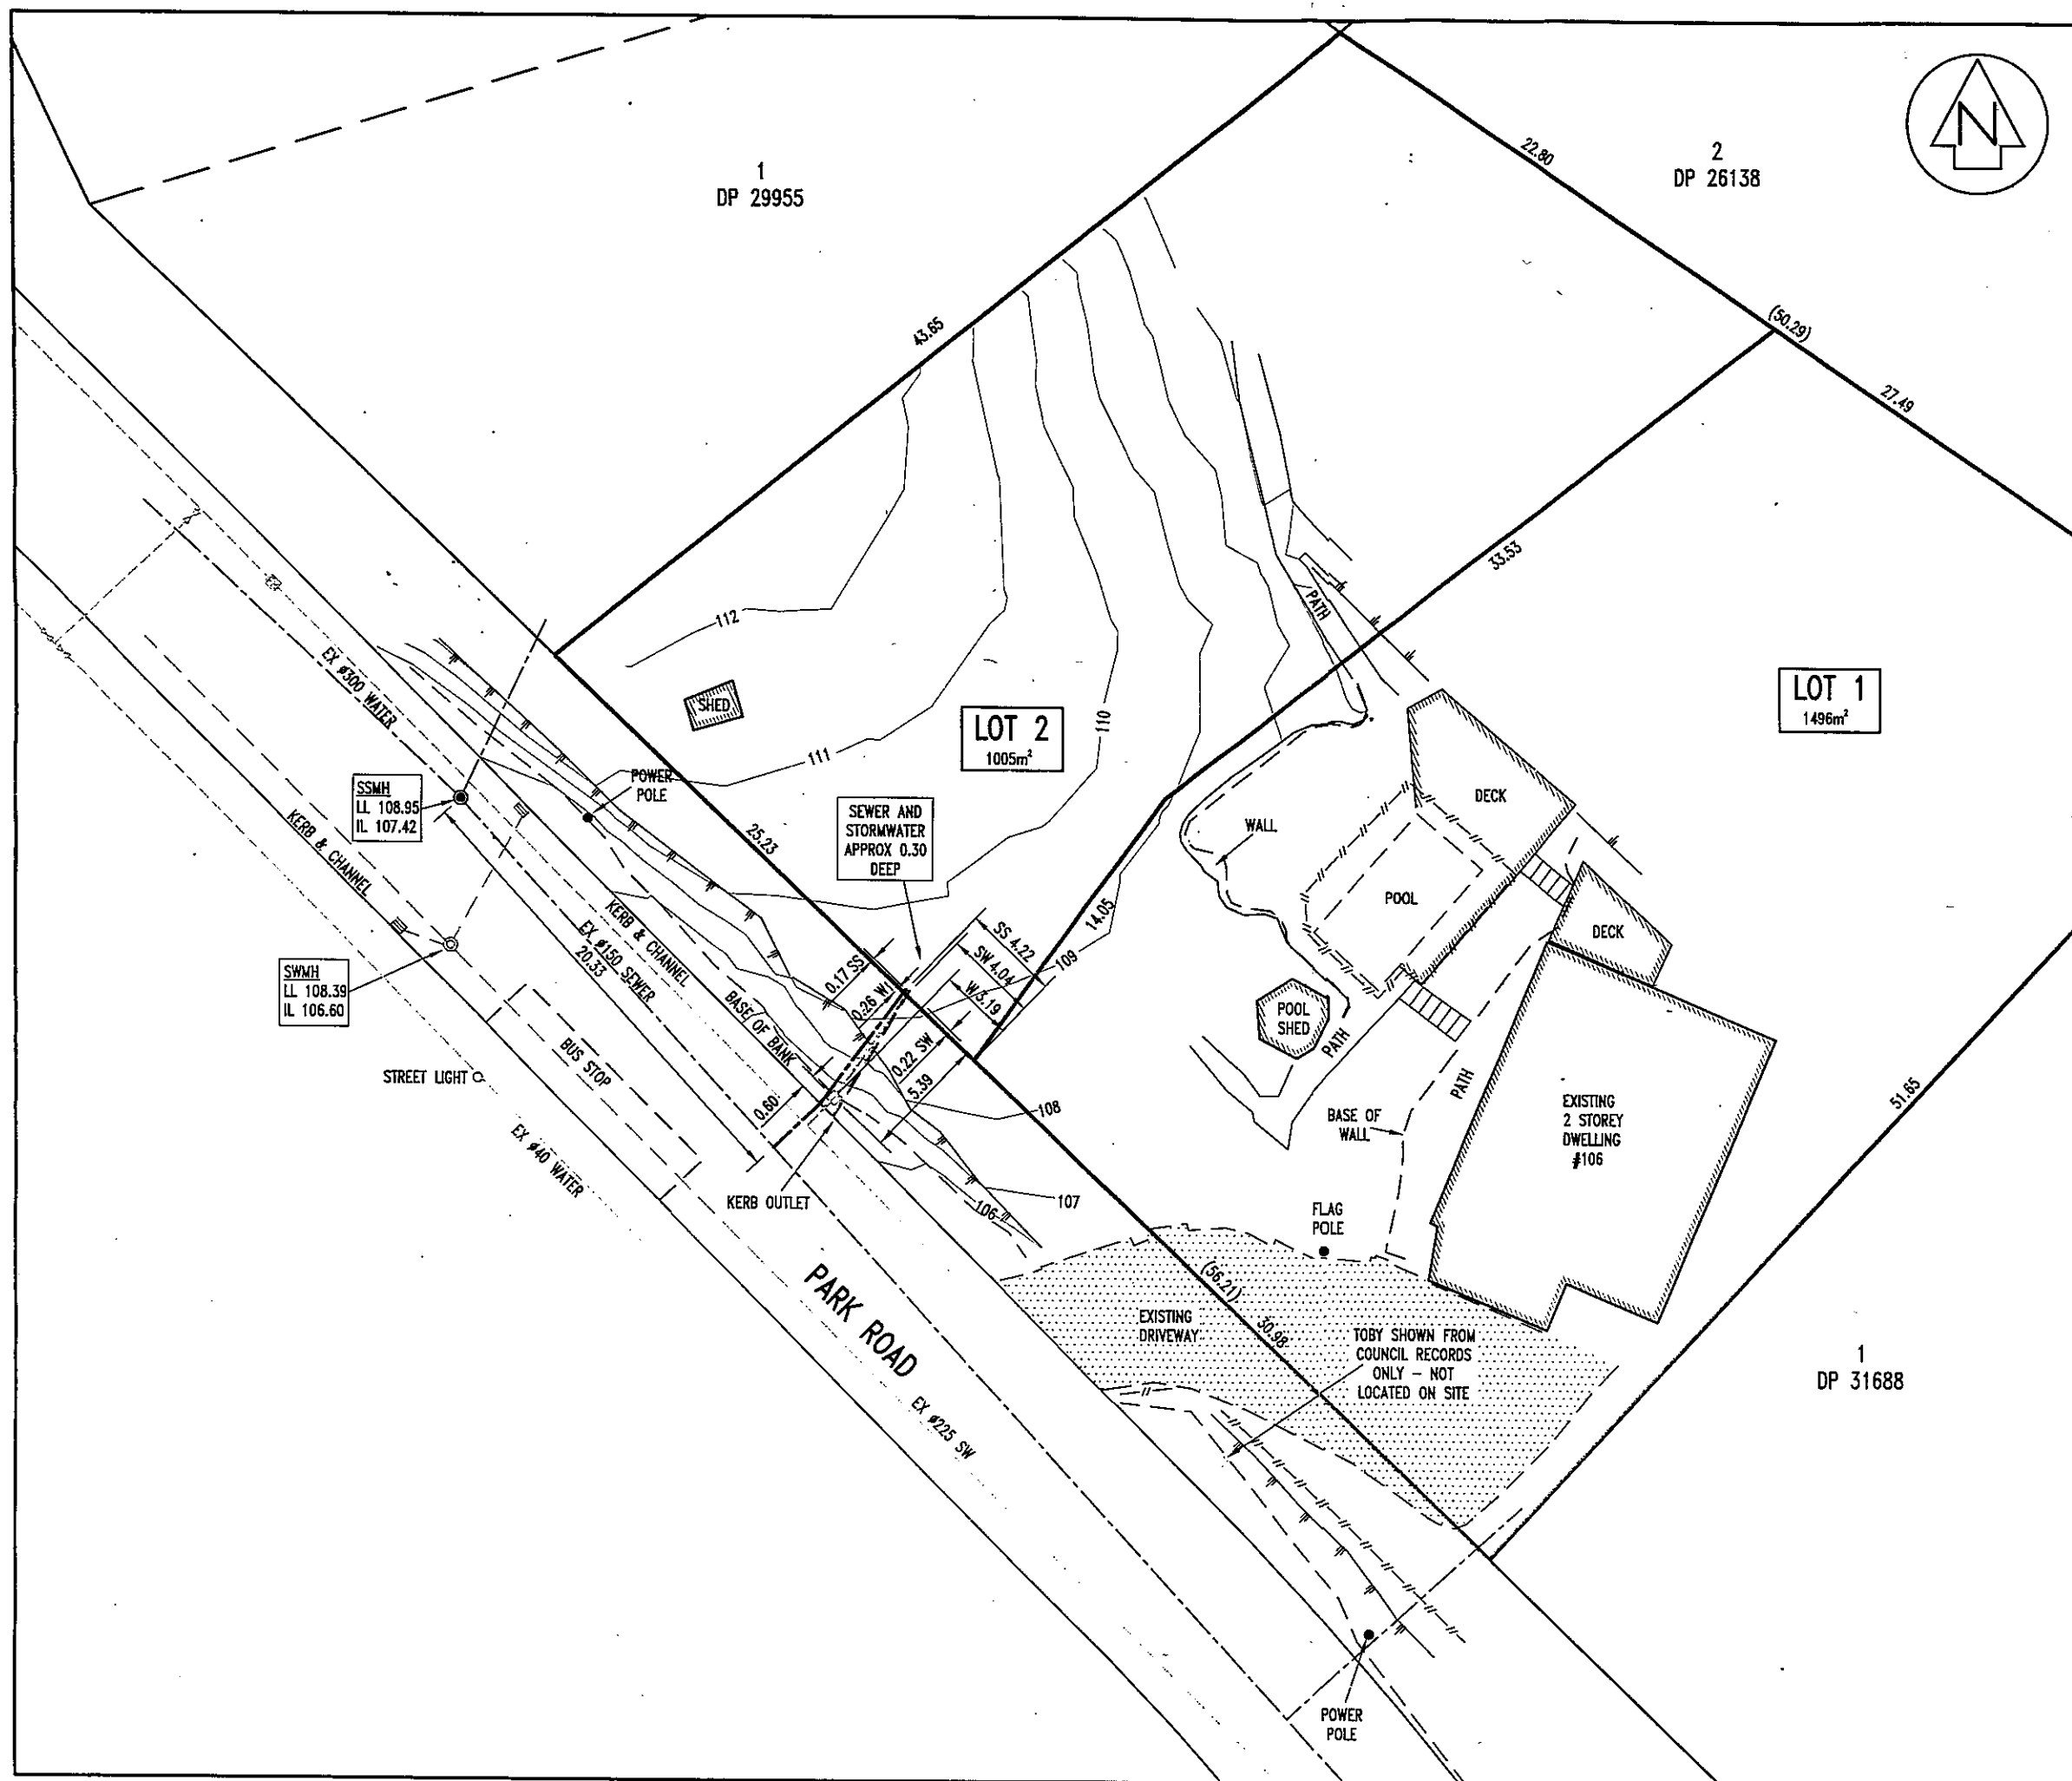

AMENDMENT	NAME	DATE

LEGEND:

---	FENCE
---	BOUNDARY
---	TOP OF BANK
---	EXISTING SEWER
---	NEW SEWER
---	EXISTING STORMWATER
---	NEW STORMWATER
---	SUMP
---	EXISTING WATER
---	NEW WATER
---	TOBY
---	VALVE

NOTES:

- LEVELS IN TERMS OF MEAN SEA LEVEL HUTT CITY DATUM. ORIGIN OF LEVELS IS HCC BM 12, RL = 113.189. CONTOURS SHOWN AT 1m INTERVALS.
- PIPE MATERIALS:
SEWER #100 uPVC SN16
SW #100 uPVC SN6
WATER 25mm OD MDPE

Cuttriss Consultants Limited
Hutt Valley, Wellington, Kapiti Coast

Cuttriss
Land Surveyors, Engineers & Resource Managers

Lower Hutt Branch - Level 3 Crest House, 92 Queens Drive, Lower Hutt
Postal Address - PO Box 30 429, Lower Hutt 5040
Telephone (04) 939 9245 Fax (04) 939 9249 Email hutt@cuttriss.co.nz

Paraparaumu Branch - 33 Kapiti Road, Paraparaumu
Postal Address - PO Box 386, Paraparaumu 5254
Telephone (04) 904 5425 Fax (04) 904 5423 Email kapiti@cuttriss.co.nz

Copyright of this drawing is vested in Cuttriss Consultants Limited

CLIENT

G & C WATTIE

JOB

ASBUILT OF
SUBDIVISION WORKS ON
PROPOSED LOTS 1&2 DP 445428
106 PARK ROAD, BELMONT

SCALE

1:200 (A4 1:400)

SIZE

A2

	NAME	DATE	DRAWING NUMBER
FIELDWORK	ESM	01/11	27621ASB
DESIGNED	-	-	
DRAWN	KML	08/11	SHEET 1 OF 1 SHEETS
CHECKED	KDG	08/11	REVISION -